


Talking Point - Grand Floor

General Notes:
Do not scale off this drawing. Read this drawing with all other architects drawn and specified information including design risk assessments.

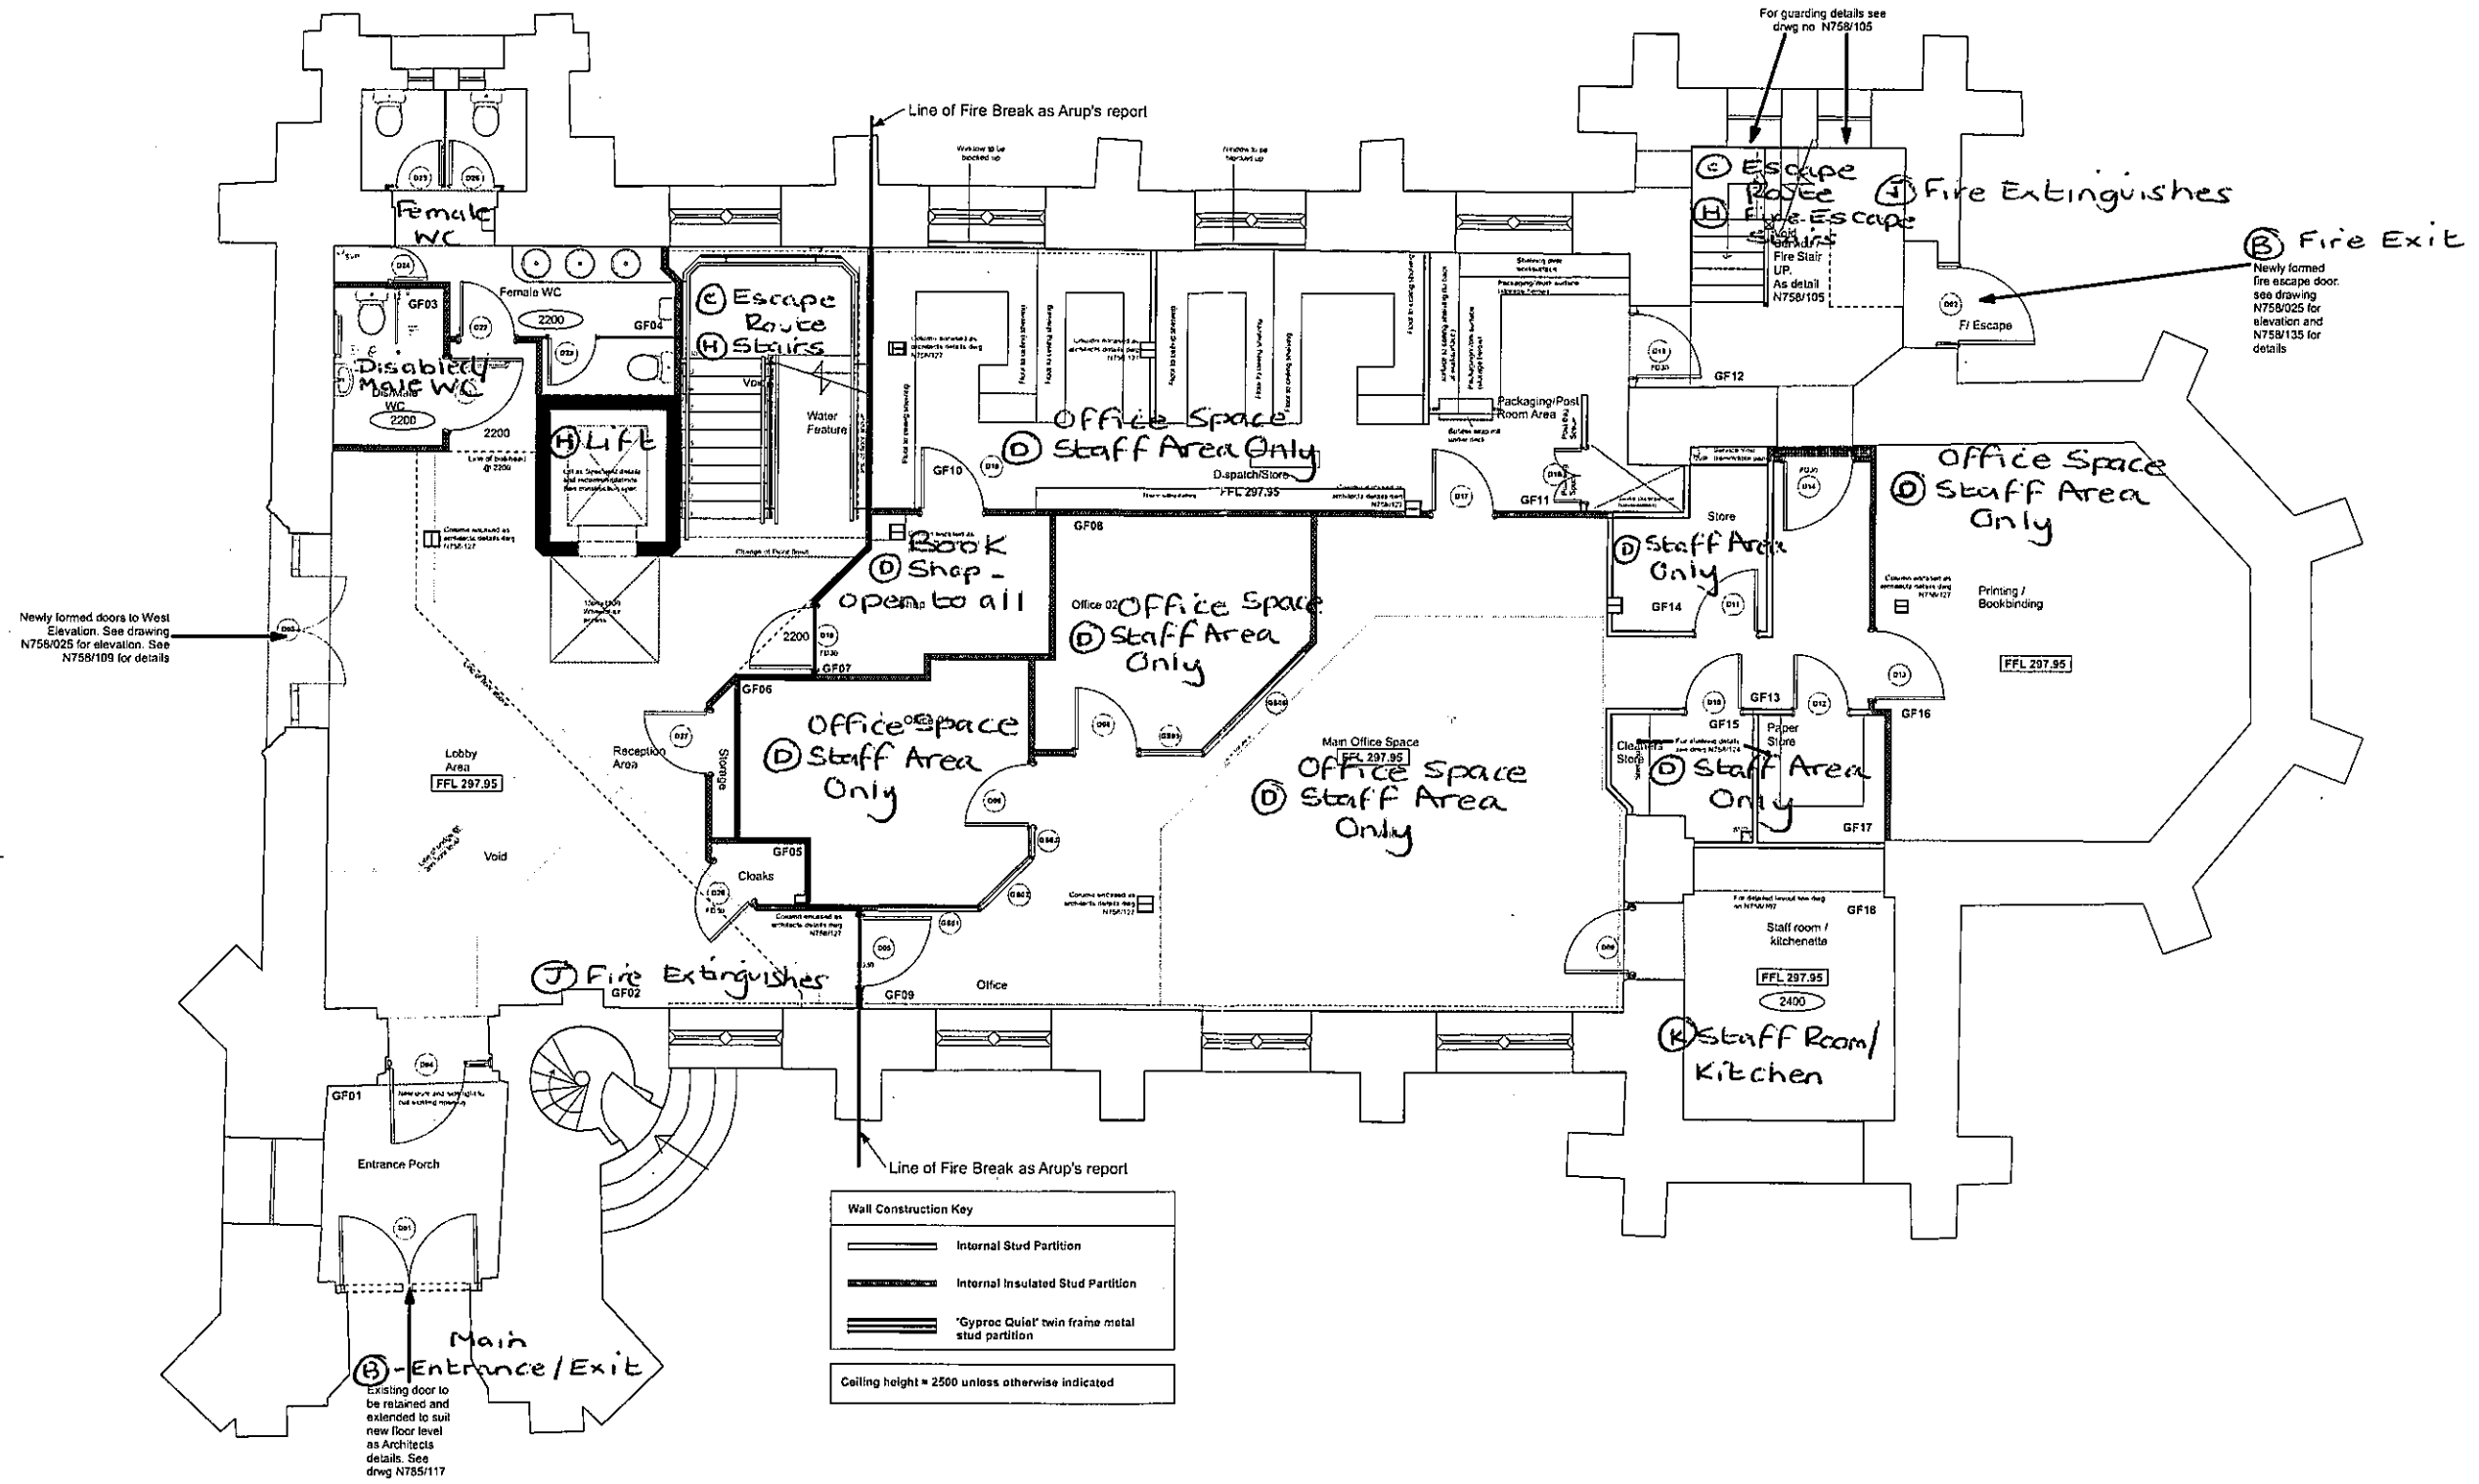

Halsall Lloyd Partnership
ARCHITECTS & DESIGNERS


Client: Focus Education
Job: St Paul's, Scouthead Saddleworth, Oldham
Dwg. Title: Ground Floor General Arrangement
Dwg. Status: AS BUILT FOR APPROVAL ONLY
Job No.: N758_34
Dwg. No.: 34
Rev.: 1:50
Date: Feb 06
Scale: 1:50
Date: Feb 06

This drawing is protected by the copyright of the Halsall Lloyd Partnership Architects & Designers

www.hlpdesign.com

Talking Point - First Floor

General Notes:
Do not scale off this drawing. Read this drawing with all other architects drawn and specified information including design risk assessments.

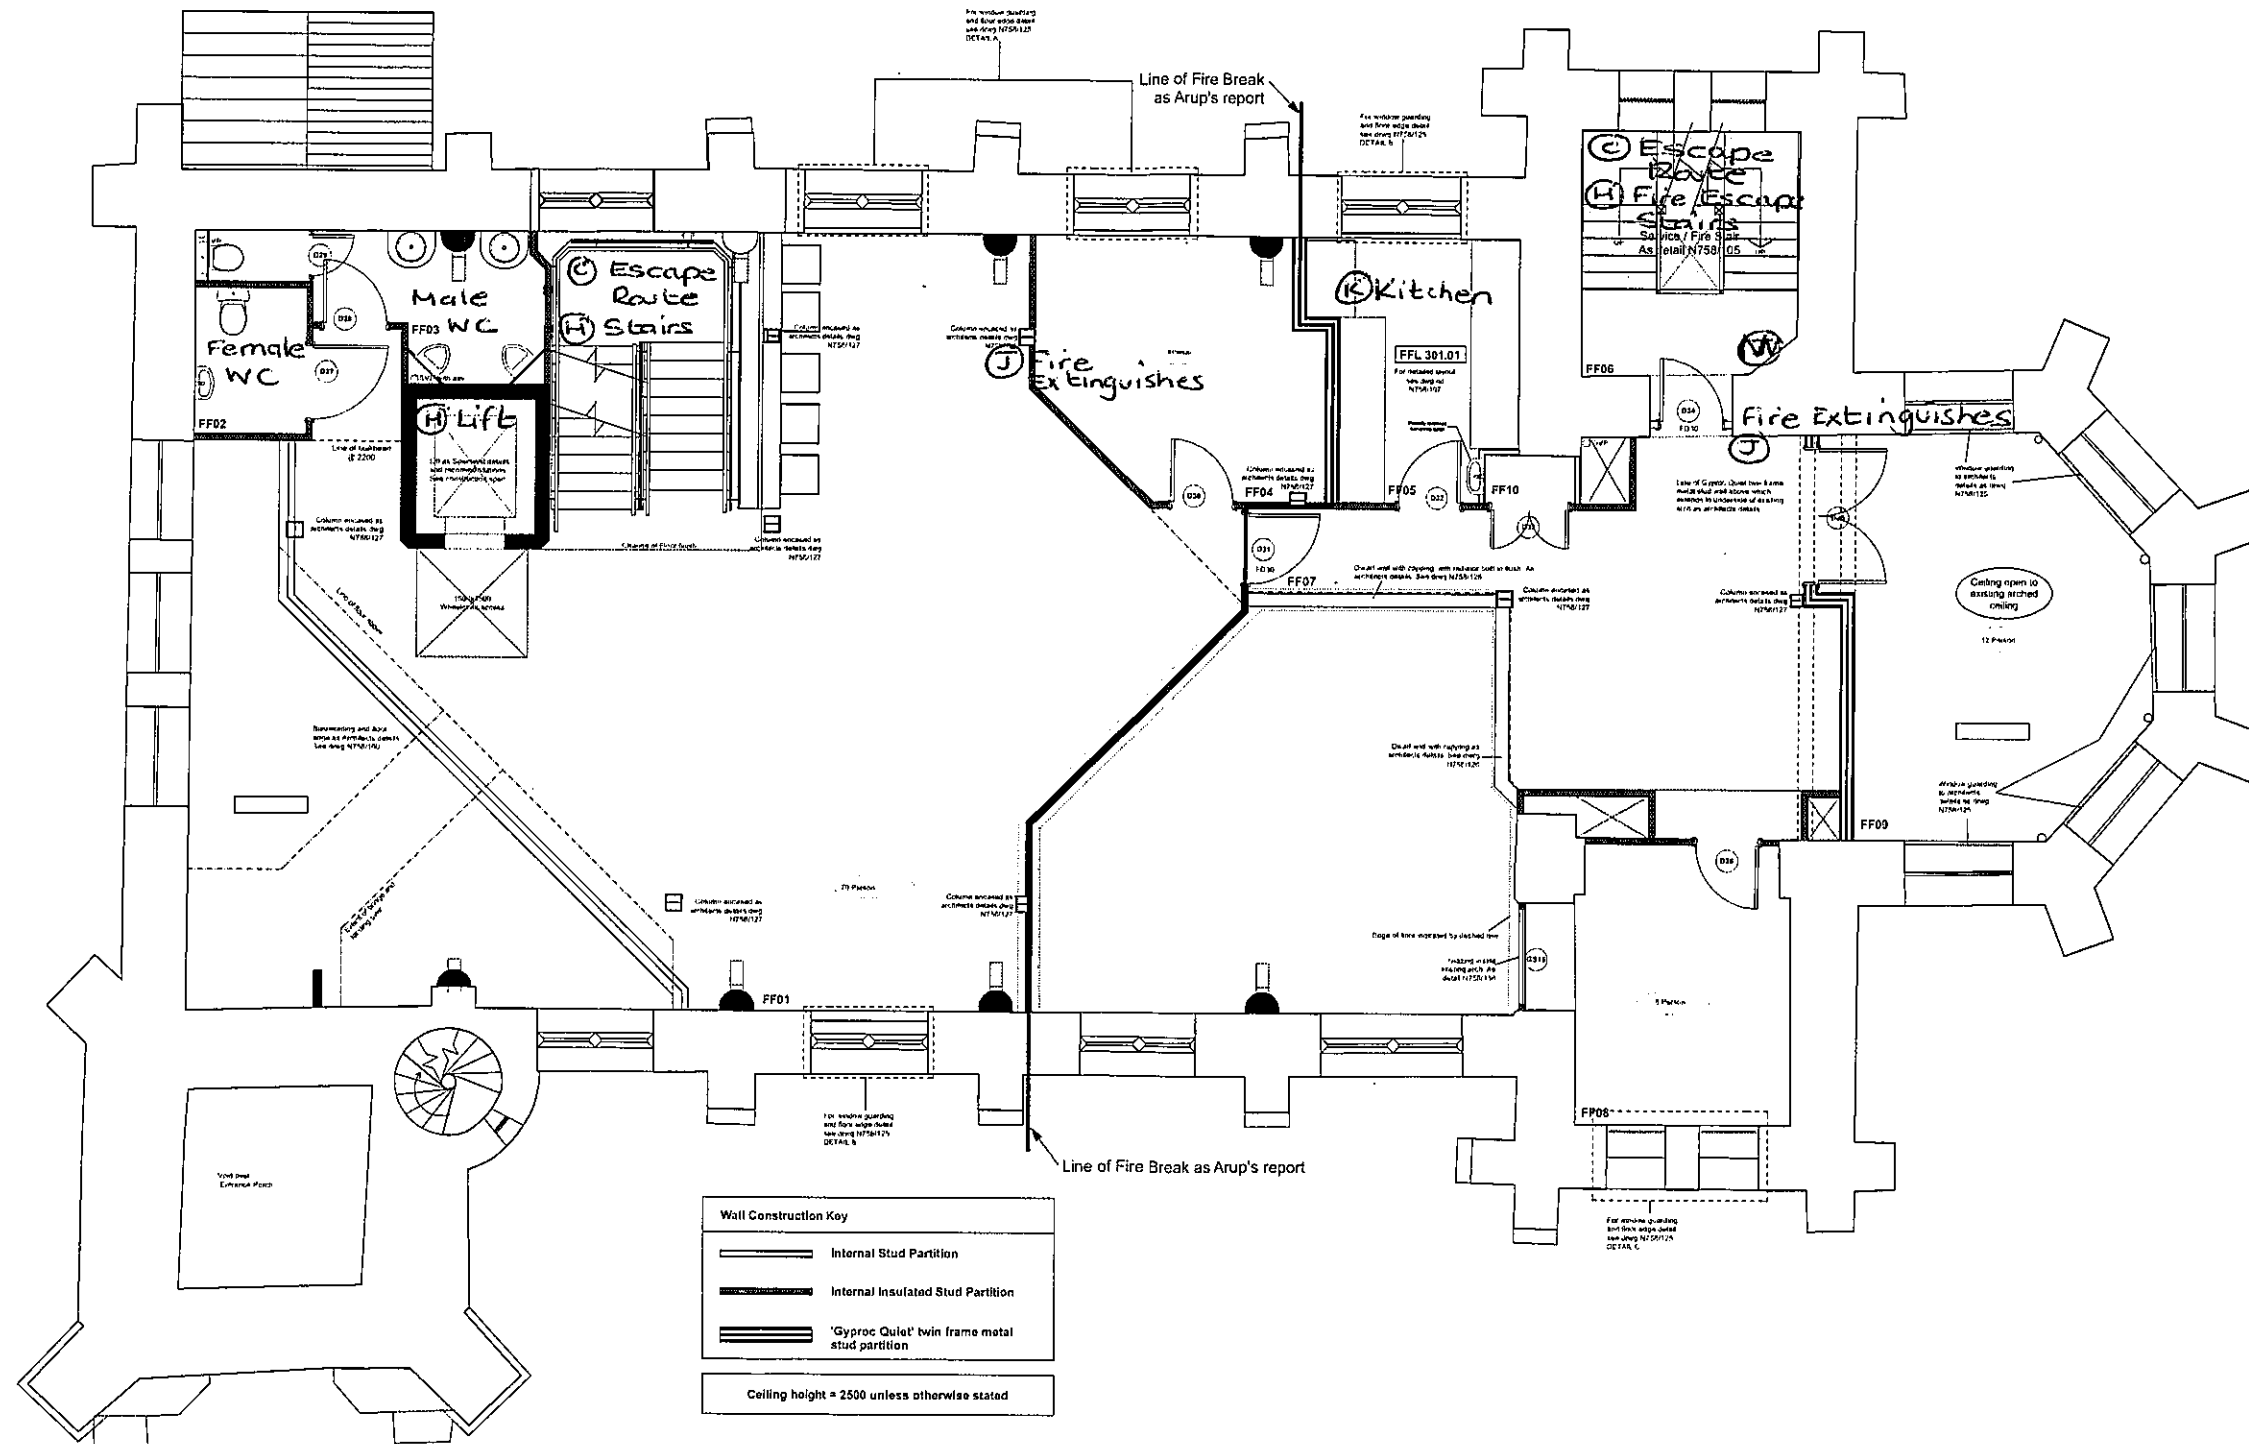

Halsall Lloyd Partnership
ARCHITECTS & DESIGNERS

Client: Focus Education
Job: St Paul's, Southend
Saddleshworth, Oldham

Dwg. Title: First Floor General Arrangement






AS BUILT FOR APPROVAL ONLY

Scale: 1:50
Date: Feb 06

This drawing is protected by the copyright of the Halsall Lloyd Partnership Architects & Designers

Talking Point - Second Floor

General Notes:
Do not scale off this drawing. Read this drawing with all other architects drawn and specified information including design risk assessments.

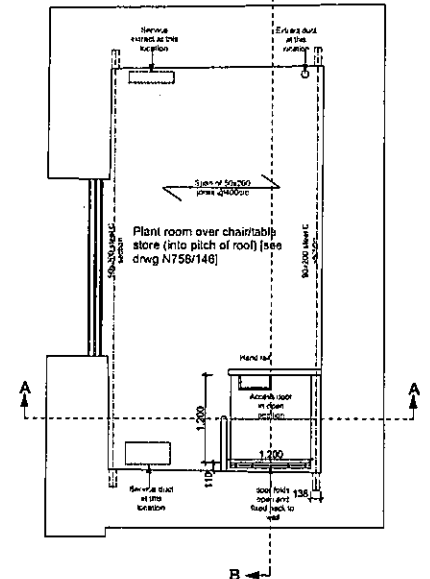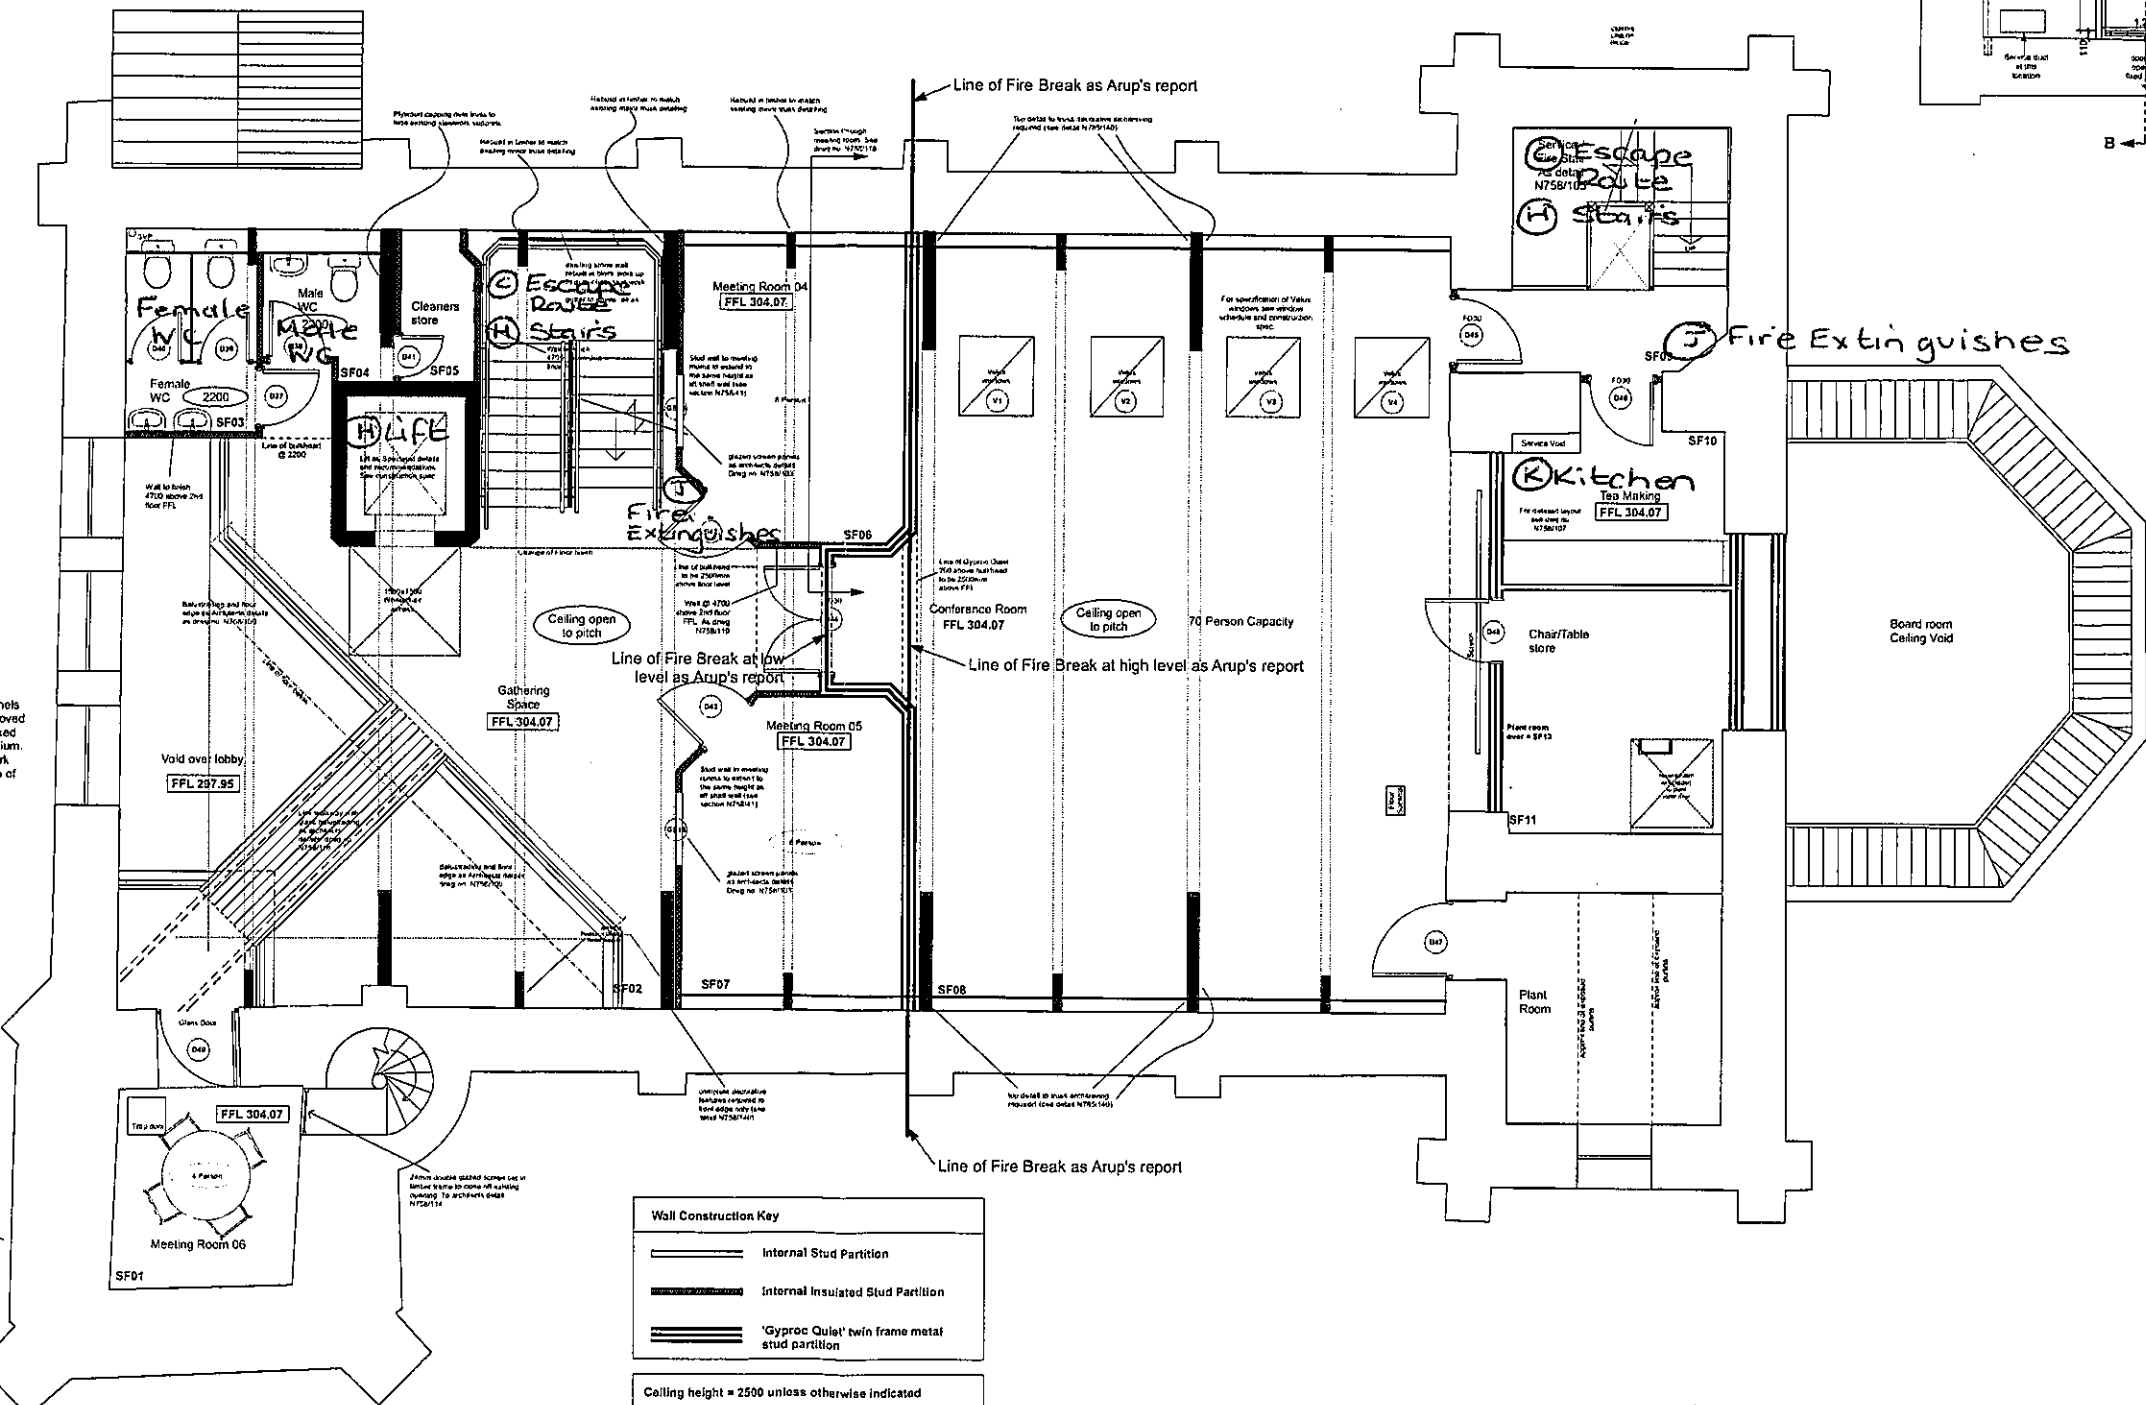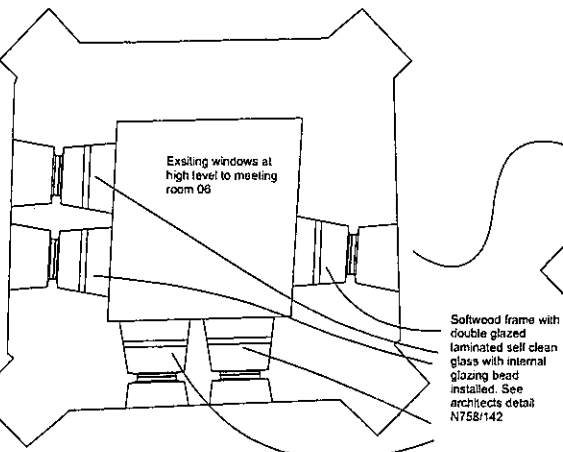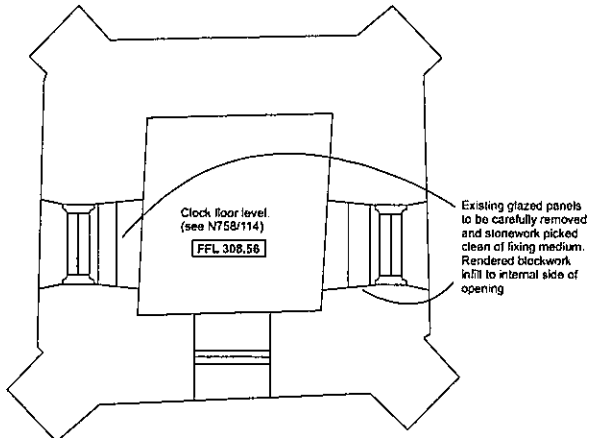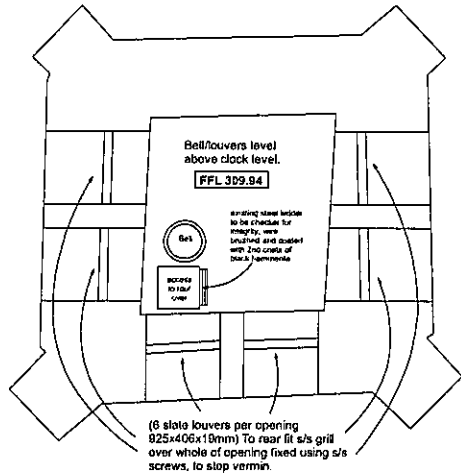

Halsall Lloyd Partnership
ARCHITECTS & DESIGNERS

Client: Focus Education
Job: St Paul's, Scouthad Saddleworth, Oldham

Drawn: AS BUILT FOR APPROVAL ONLY
Job No: N758 | 36 | Rev: 1:50
Date: Feb 06

Drawn: [Signature]
Checked: [Signature]
Date: Feb 06

This drawing is protected by the copyright of the Halsall Lloyd Partnership Architects & Designers